


REVISIONS MADE BY THE CITY OF SAULT STE. MARIE


Red-line changes to show 4 additional parking spaces (1 parking space/unit) & aisle alignment.

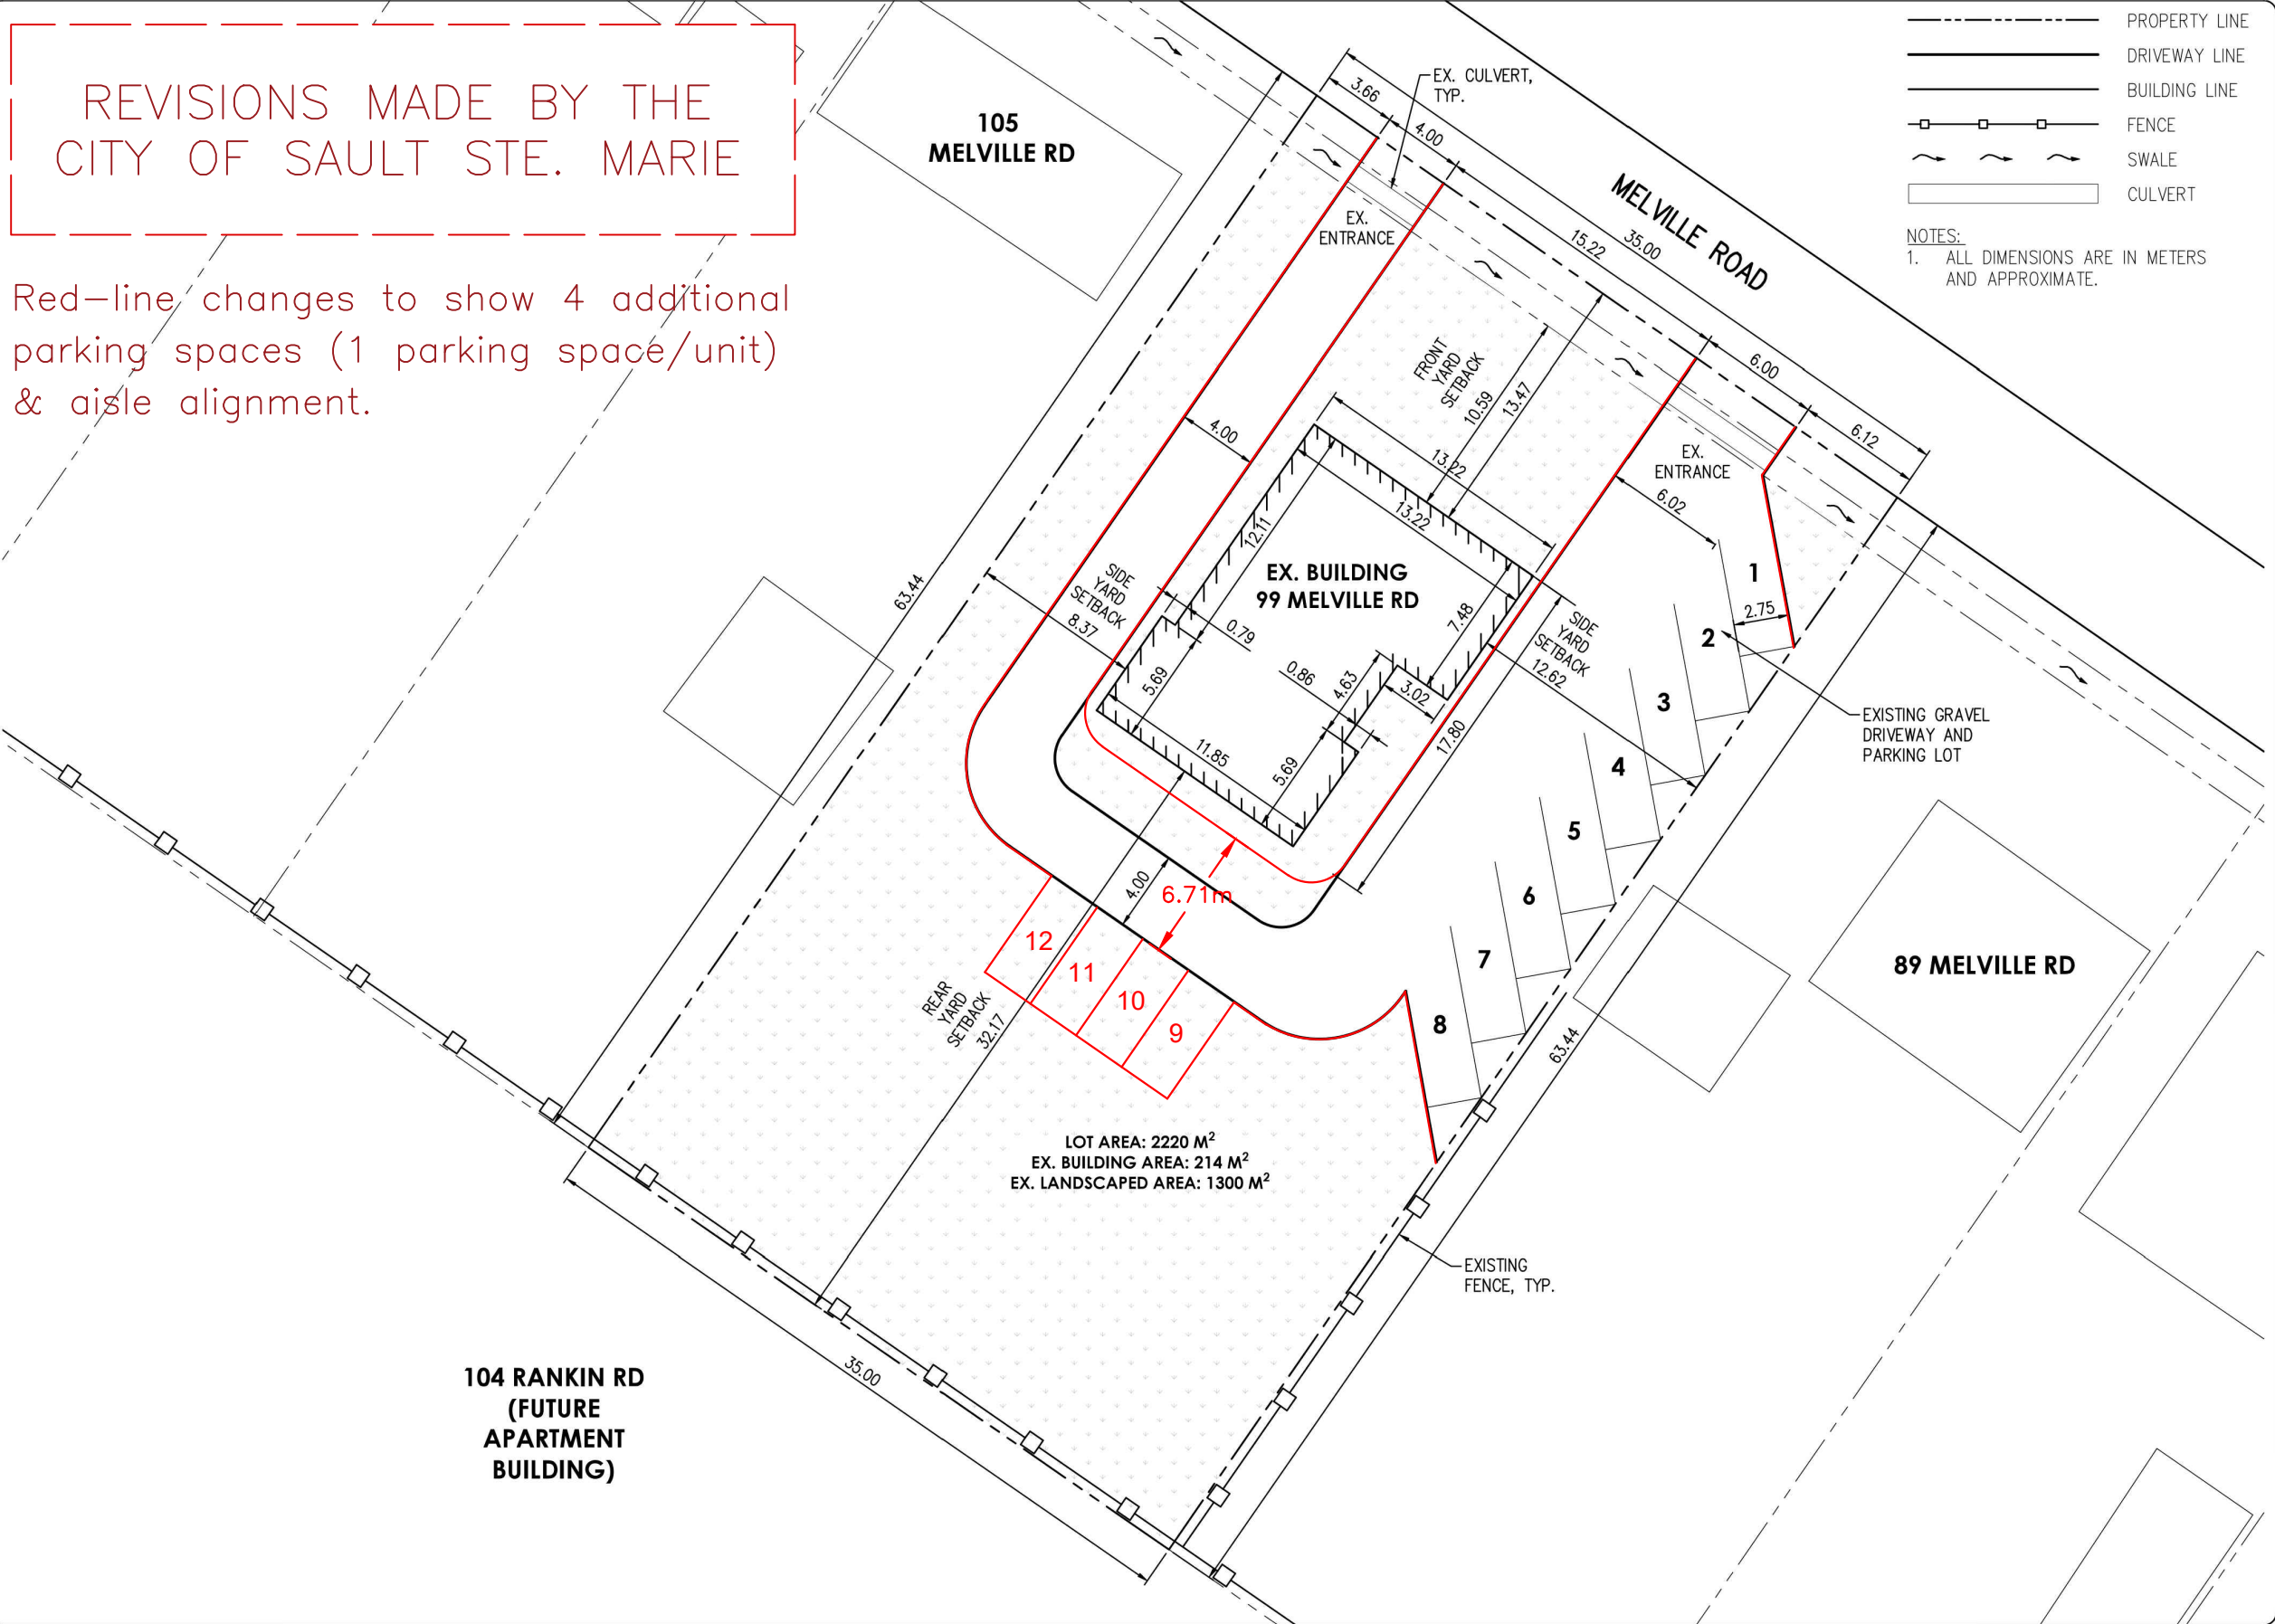

- PROPERTY LINE
- DRIVEWAY LINE
- BUILDING LINE
- FENCE
- ~ SWALE
- ▭ CULVERT

NOTES:
 1. ALL DIMENSIONS ARE IN METERS AND APPROXIMATE.

SEAL

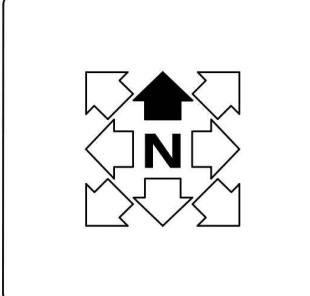

REVISIONS		
REV#	DESCRIPTION	DATE
A	FOR REZONING APPLICATION	2025-02-19

PROJECT:
 99 MELVILLE RD,
 SAULT STE. MARIE, ON
 P6A 5J6

DRAWING TITLE:
 SITE PLAN

DRAWN: MS
 CHECKED: MS
 DATE: 2025-02-12

SHEET 1 OF 1
SK1
 SCALE: 1:8